



August 30, 2019

TO THE PROSPECTIVE BIDDER:

RE: Hartford Avenue Rehabilitation from SE 22nd Stret to Cownie Soccer Complex
Activity ID: 06-2019-017

We are issuing Addendum No. 1 on the above-referenced project. This Addendum No. 1 modifies, supplements, or replaces information contained in the contract documents. This addendum is hereby made a part of the contract documents.

Each bidder shall acknowledge receipt of each addendum in its proposal in order to have its bid read and considered. Acknowledgment of the receipt of each addendum shall be made by inserting the number of each addendum in the appropriate blank provided for such acknowledgment in the proposal.

The original proposal shall be used to bid this project.

The current bidders list is available on our web page:
<https://www.dsm.city/ProjectBidInfo>

If you have any questions regarding this Addendum No. 1, please contact the Project Manager, Joseph Eddy at 515-283-4034.

Sincerely,

A handwritten signature in black ink that reads "Steven L. Naber". To the right of the signature, the initials "RN" are written in red ink.

Steven L. Naber, P.E.
City Engineer

ADDENDUM NO. 1
ON
HARTFORD AVENUE FROM SE 22ND STREET TO COWNIE
SOCCER REHABILITATION
ACTIVITY ID 06-2019-017

August 30, 2019

| <u>ITEM NO.</u> | <u>DESCRIPTION</u> | <u>PAGE</u> |
|-----------------|-----------------------------|-------------|
| 1 | Plan Sheet B.01 Replacement | 1 |



1. Plan Sheet B.01 Replacement

The attached Sheet B.01 replacement includes the following changes/clarifications to the 'Subdrain Detail'.

- A. Change distance from crown to subdrain invert/bottom of modified subbase layer to 16" instead of 1'.
- B. Clarified thickness of modified subbase to be 6" at the edge of the pavement and 10" at the crown.
- C. Clarified that the 4" transverse subdrain outlet is to be sloped to drain.

End of Addendum No. 1

DMK

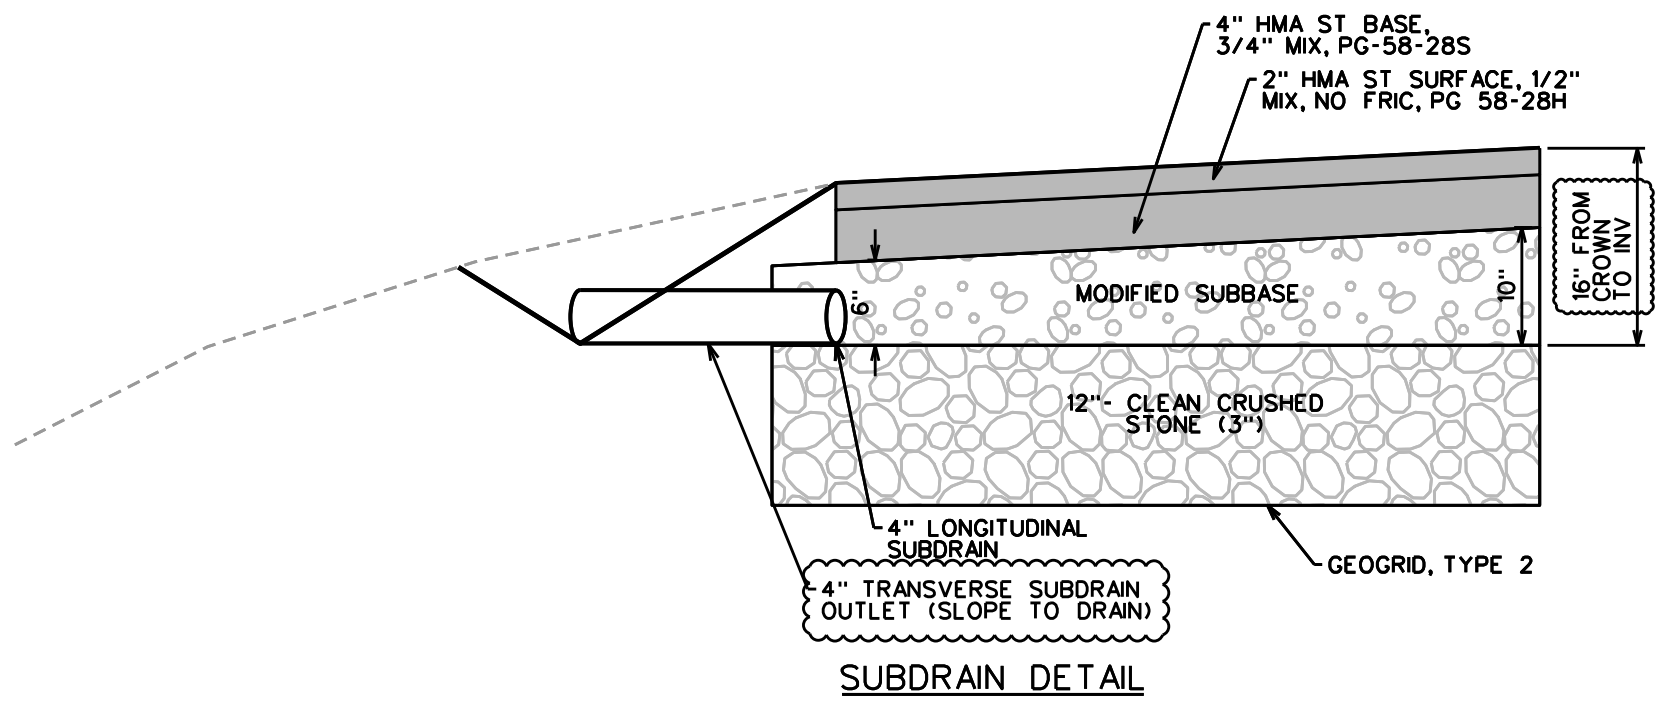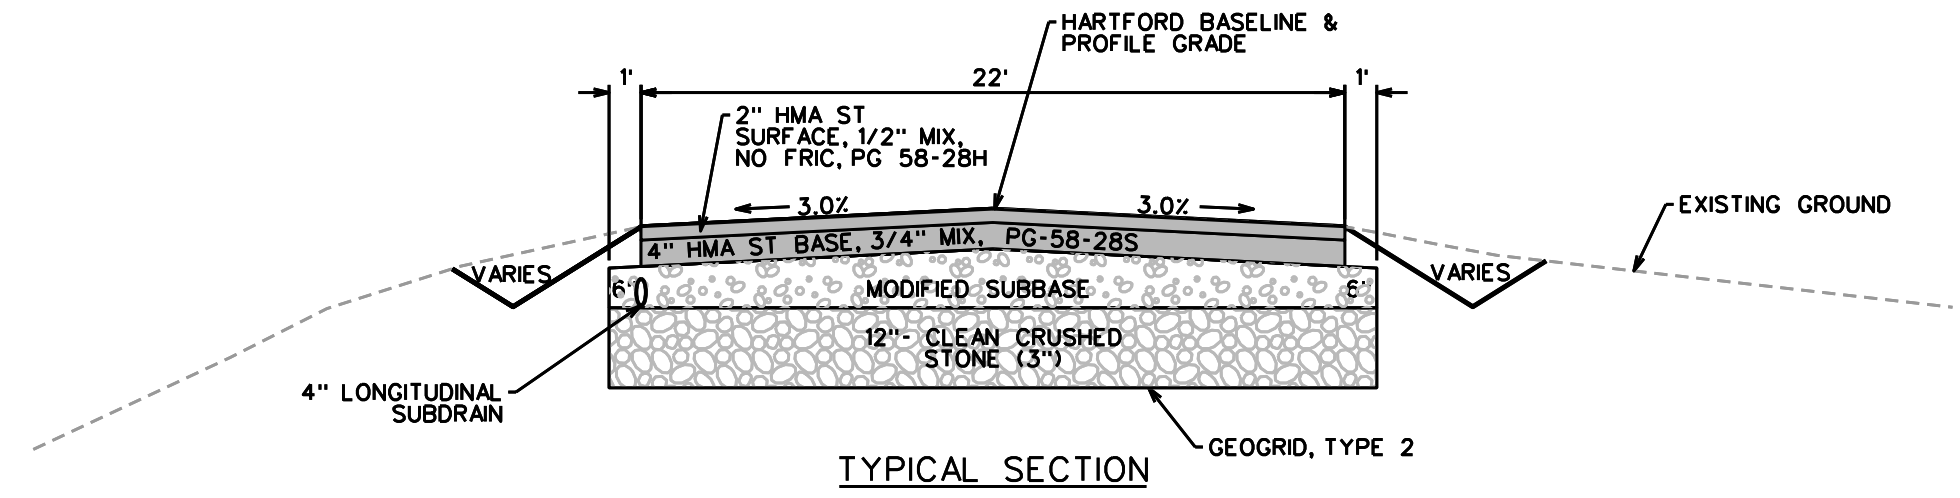

GRAPHIC SCALE

| | | | | | | | | | | | | |
|----------------|---------|-----|---|-----------------|--------------|----------------|----------|------------|------------|-----|--------|--------|
| ADDENDUM NO. 1 | 8/30/19 | JAE | PROJECT | HARTFORD AVENUE | DESIGNED BY | JAE | DRAWN BY | BCH | CHECKED BY | DMK | SURVEY | 190030 |
| | | | FROM SE 22 STREET TO CONNIE SOCCER REHABILITATION | | ACTIVITY NO. | 06-2019-017 | DATE | 07-31-2019 | | | | |
| | | | DEPARTMENT OF ENGINEERING | | SHEET TITLE | DESIGN DETAILS | | | | | | |
| | | | CITY OF DES MOINES, IOWA | | | | | | | | | |
| | | | (515) 283-4931 | | | | | | | | | |
| MARK | DATE | BY | | | | | | | | | | |